


SECTION 03 scale 1:50

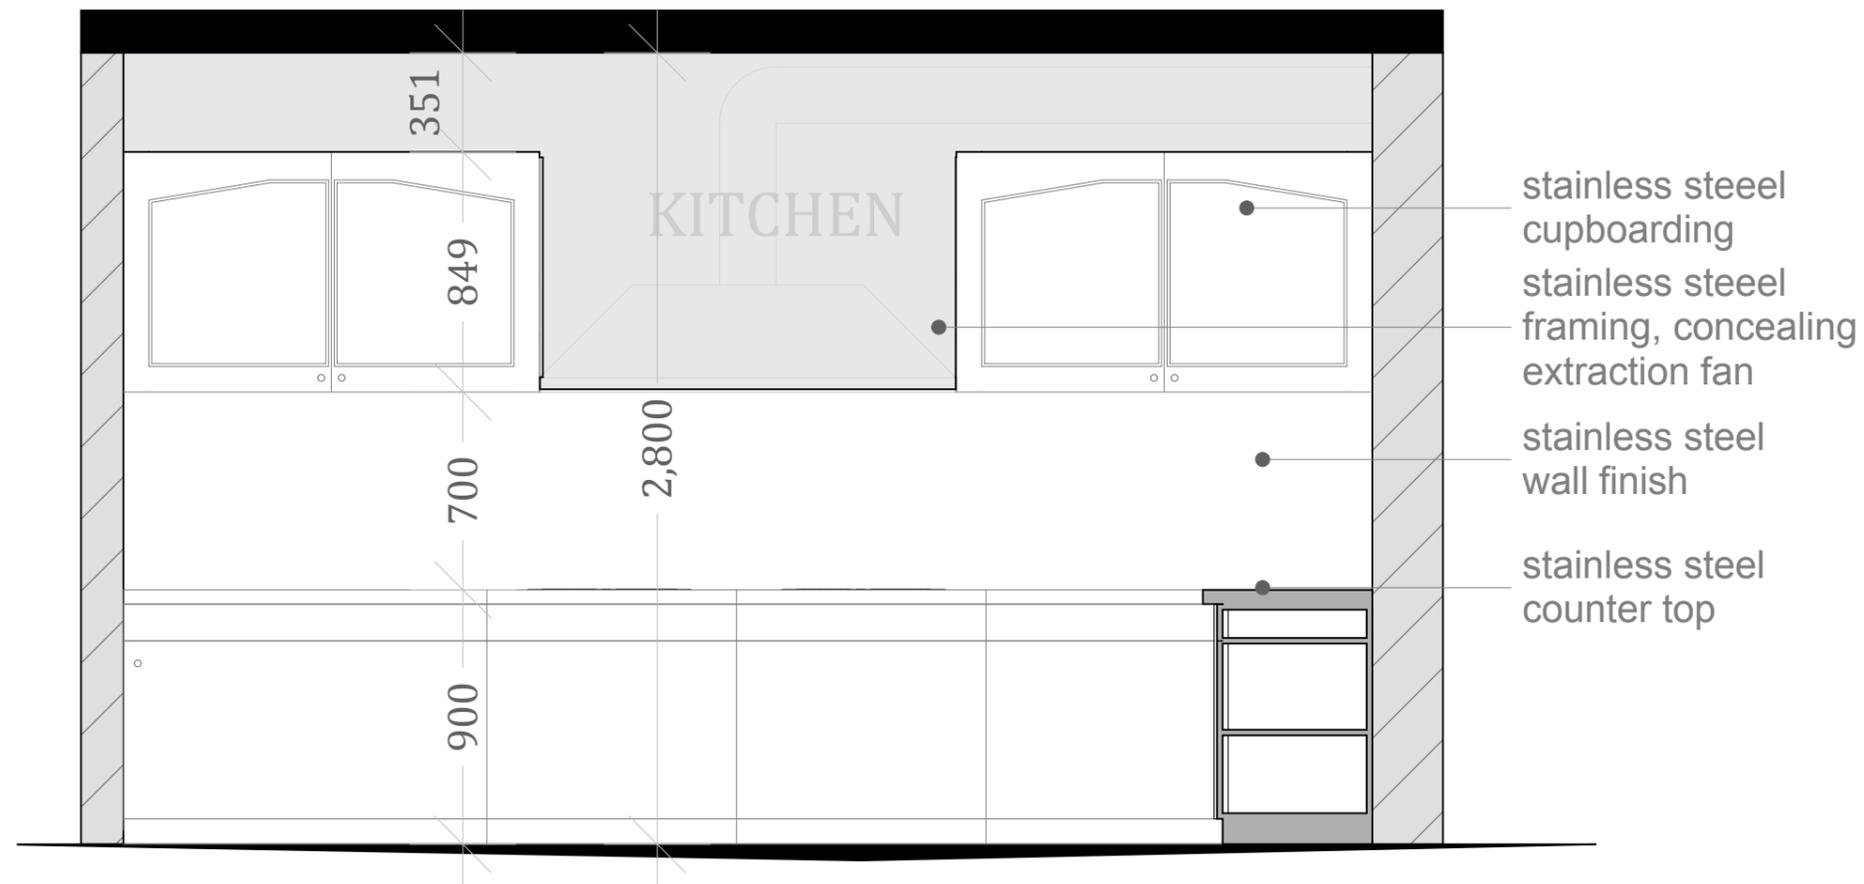

SECTION 02 scale 1:25

ALL DIMENSIONS SHALL BE CHECKED AND CORRELATED WITH RELEVANT DRAWINGS ON SITE. ANY DISCREPANCY SHALL BE BROUGHT TO THE NOTICE OF THE ARCHITECT.

Date	No.	REVISIONS	Date	No.	PRINTS TO	Concept By	Project
			DEC/14			WMS	AS BUILT FLOOR PLANS FOR US EMBASSY WAREHOUSES AND OFFICES, BUGOLOBI
						Drawn By	
						N.C	Title
						Scale	

Project Managers:

WALTER CLAUDE & ASSOCIATES
 Architects & Planning Consultants
 Plot 45 , Kira Rd, Kamwokya.
 P.O.Box 8292 Kampala.
 Tel:031-2284704