


ng

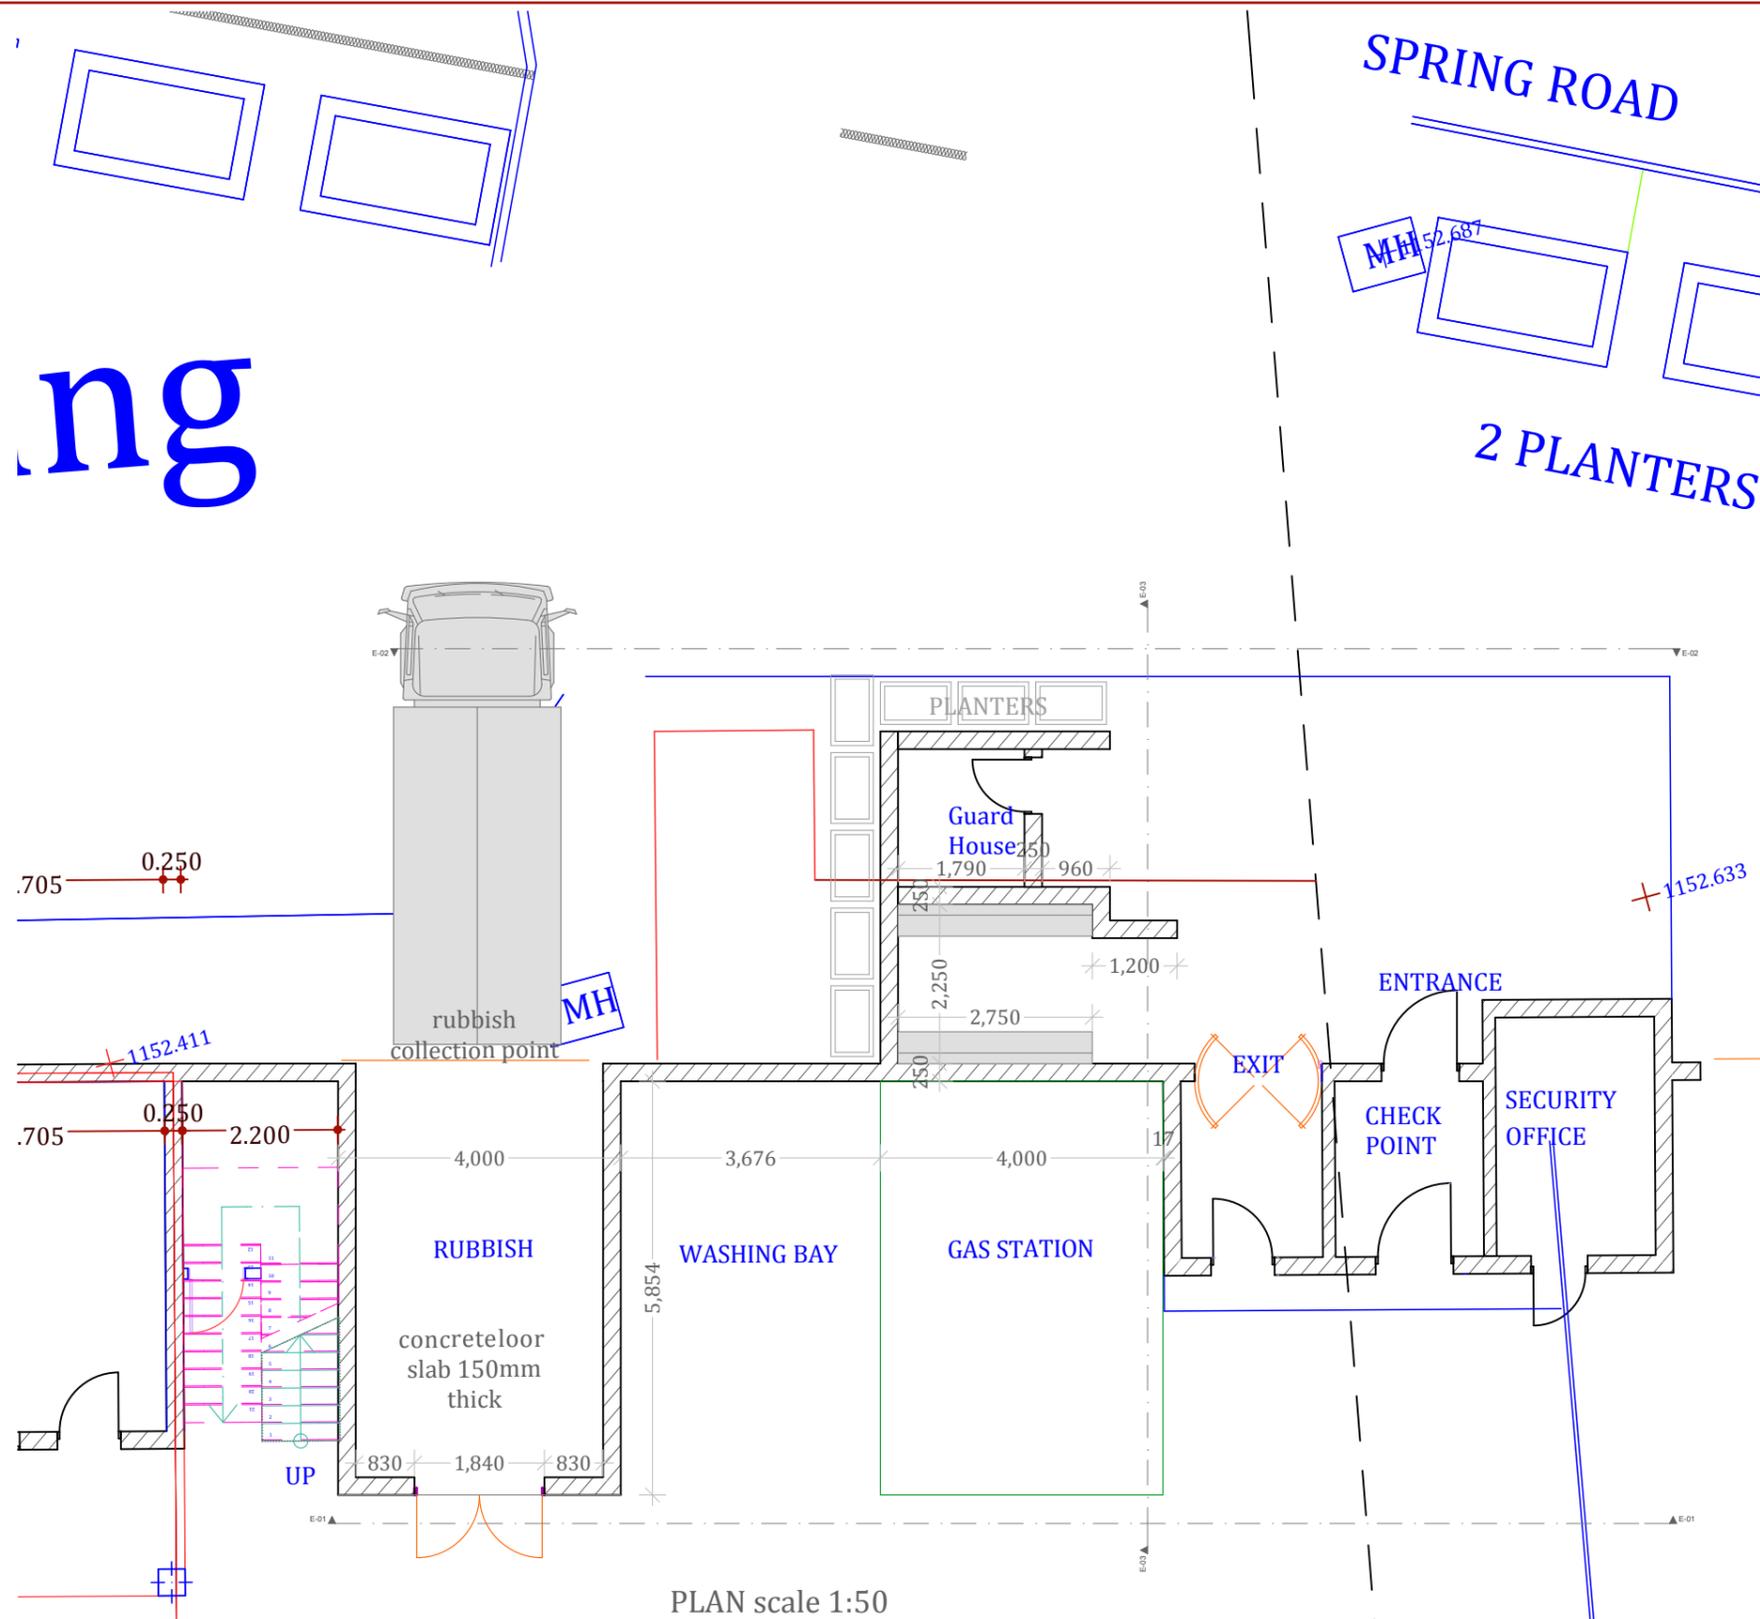

ALL DIMENSIONS SHALL BE CHECKED AND CORRELATED WITH RELEVANT DRAWINGS ON SITE. ANY DISCREPANCY SHALL BE BROUGHT TO THE NOTICE OF THE ARCHITECT.

Date	No.	REVISIONS	Date	No.	PRINTS TO
			DEC/14		

Concept By	WMS
Drawn By	N.C
Scale	

Project	AS BUILT FLOOR PLANS FOR US EMBASSY WAREHOUSES AND OFFICES, BUGOLOBI
Title	

Project Managers:



WALTER CLAUDE & ASSOCIATES  
Architects & Planning Consultants

Plot 45 , Kira Rd, Kamwokya.  
P.O.Box 8292 Kampala.  
Tel:031-2284704