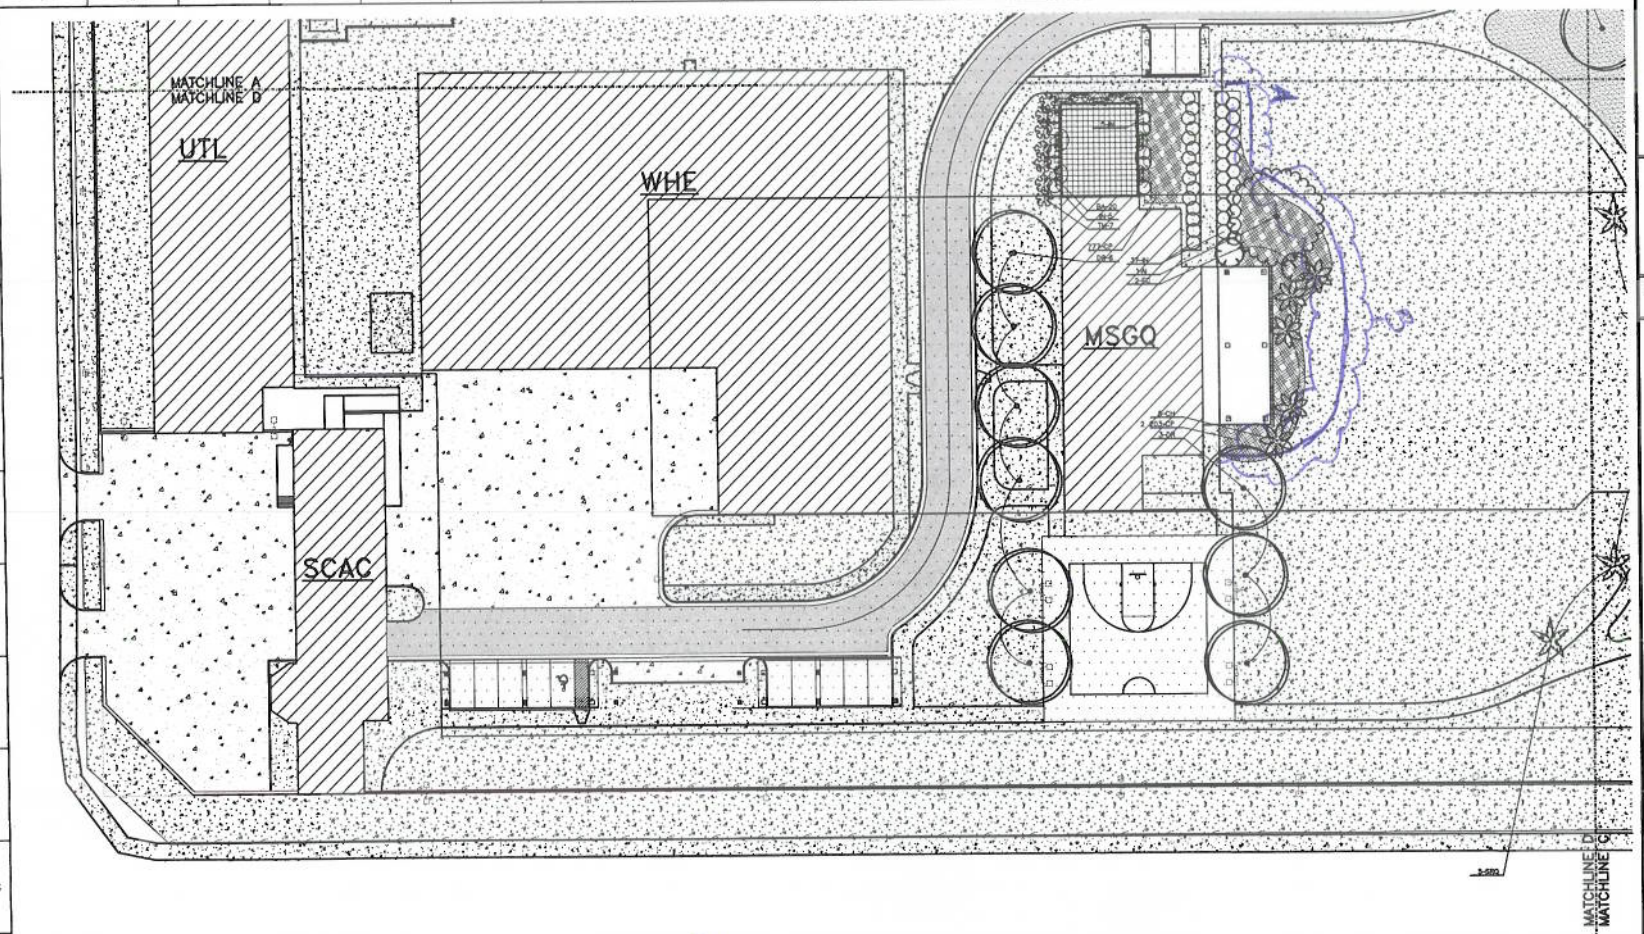

A - 15cm x 25cm border
B - 1m x 15cm knee wall

PLANT SCHEDULE

TREES	BOTANICAL	COMMON	CONT	CAL	SIZE	REMARKS	QTY	DETAIL
AI	Azadirachta indica	Neem Tree	B & B	75mm Cal	4.0 M TALL	ADAPTED	8	1, CMPD L8.802
CH	Chamaerops humilis	Mediterranean Fan Palm	B & B	50mm Cal	Multi Stem	ADAPTED	22	4, CMPD L8.802
DR	Delonix regia	Royal Poinciana	Box	75mm Cal	4.0 M TALL	ADAPTED	10	1, CMPD L8.802
FC	Ficus citrifolia	Wild Banyan Tree	Box	75mm Cal	4.0 M TALL	ADAPTED	9	1, CMPD L8.802
PD	Phoenix dactylifera	Egyptian Palm	Box		3.5M to Base	ADAPTED	19	4, CMPD L8.802
SRQ	Phoenix dactylifera	Date Palm	Box		3.5M to Base	ADAPTED	52	4, CMPD L8.802

SHRUBS	BOTANICAL	COMMON	CONT	REMARKS	QTY	DETAIL
BA	Bougainvillea alexandria	Bougainvillea	11 lt. pot	ADAPTED	10	2, CMPD L8.802
HS	Hibiscus syriacus	Rose of Sharon	11 lt. pot	ADAPTED	77	2, CMPD L8.802
IN	Ixora coccinea 'Nora Grant'	Red Ixora	11 lt. pot	ADAPTED	150	2, CMPD L8.802
TM	Thevetia peruviana	Yellow Oleander Multi-Trunk	11 lt. pot	ADAPTED	106	2, CMPD L8.802

GROUND COVERS	BOTANICAL	COMMON	CONT	REMARKS	QTY	DETAIL
CP	Carpobrotus glaucescens	Pig Face	1 lt. @ 0.30m oc	ADAPTED	7,519	3, CMPD L8.802
VM	Catharanthus roseus	Madagascar Perivinkle	1 lt. @ 0.30m oc	ADAPTED	324	3, CMPD L8.802
IP	Ipomoea pes-caprae	Pohuehue	1 lt. @ 0.30m oc	ADAPTED	1,297	3, CMPD L8.802

REFERENCE NOTES SCHEDULE

SYMBOL	REFERENCE NOTES
1	EDGING, SEE DETAIL 5, CMPD L8.802
	LAWN
	ROCK MULCH

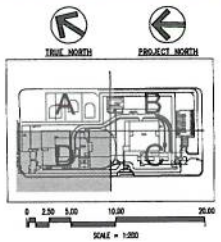

United States Department of State
OVERSEAS BUILDINGS OPERATIONS
Washington, D.C.

UNITED STATES EMBASSY for DJIBOUTI
REPUBLIC OF DJIBOUTI

WARNING: This document is the property of the U.S. Government. Further reproduction and/or distribution is prohibited without the express written permission of Overseas Buildings Operations, U.S. Department of State, Washington, DC, 20522-0625. Information on this document is not to be altered except with the written approval of the individual whose seal appears hereon.

RECORD "AS-BUILT" DRAWING
THE INFORMATION ON THIS DRAWING INDICATES DRAWINGS MADE TO THE CONSTRUCTION DOCUMENTS AS RECORDED BY THE CONTRACTOR AND TRANSFERRED TO THE REPRODUCIBLE DRAWINGS BY THE ARCHITECT. THE ARCHITECT ASSUMES NO RESPONSIBILITY FOR THE ACCURACY OR RELIABILITY OF THE INFORMATION PROVIDED.

Rev. Number	Description	Date
	RECORD "AS-BUILT" DRAWING	

Revisions

CADDELL

INTÉGRUS ARCHITECTURE

Release For Construction

Drawing Title: LANDSCAPE PLAN 'D'

CADD File Name: CMPDL8.11
Drawing Scale: 1:200
Plot Scale:
Date: 7-21-09
Drawn By: HJS
Checked By:
Project Number: 20833.00
Classification: UNCLASSIFIED
Sheet Number: CMPD L8.115

RECORD "AS-BUILTS" DRAWING

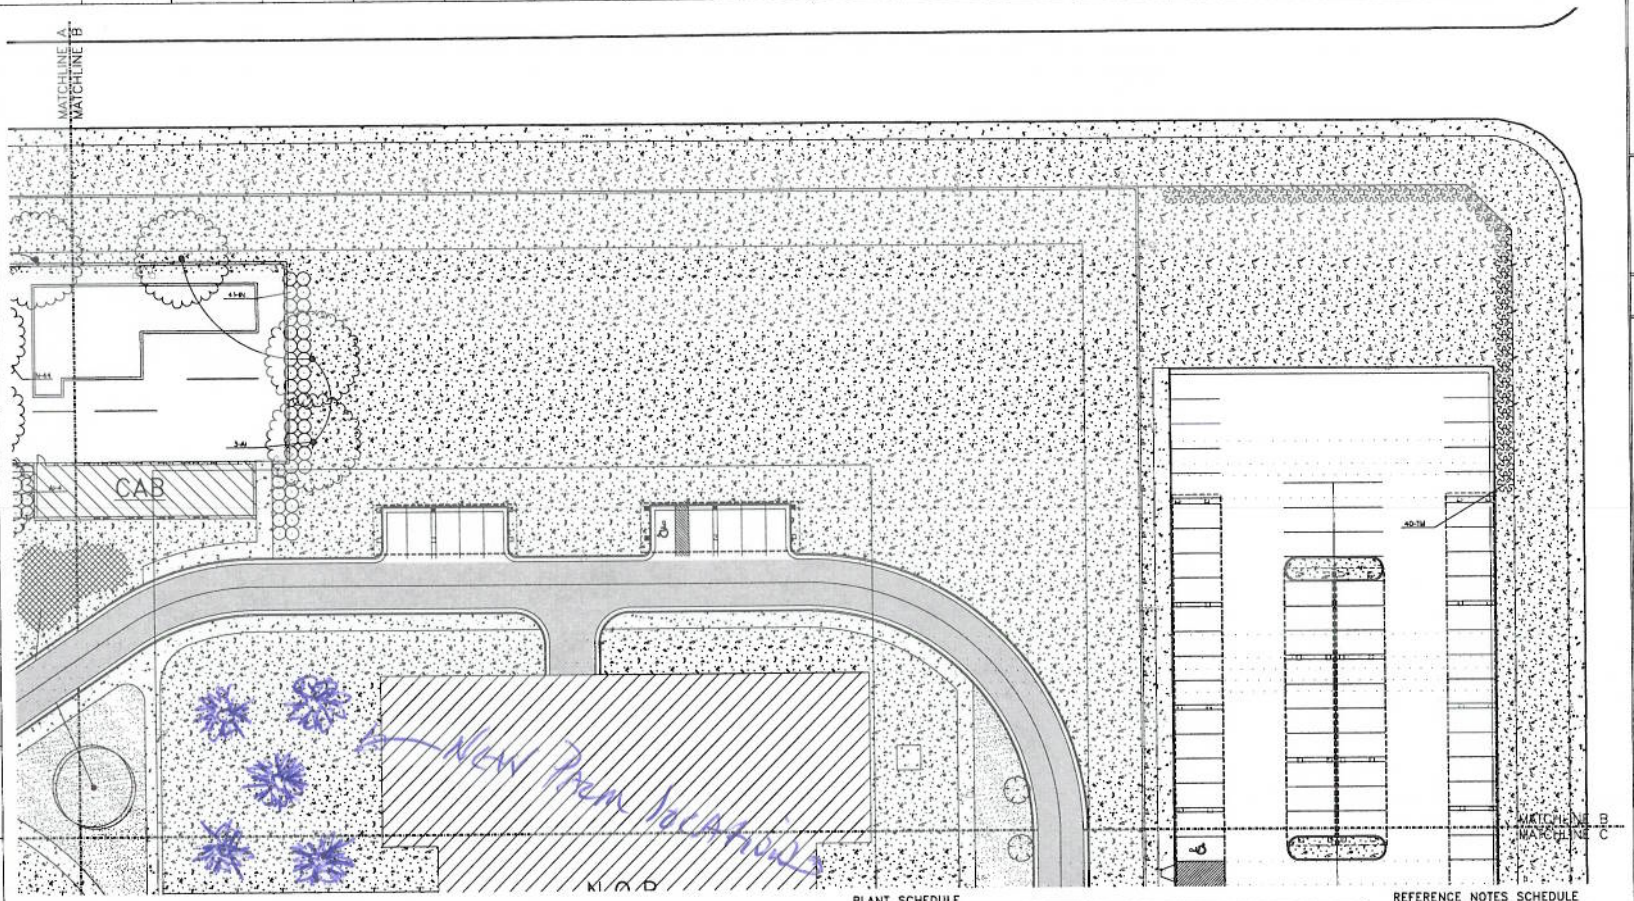

PLANT SCHEDULE

TREES	BOTANICAL	COMMON	CONT	CAL	SIZE	REMARKS	QTY	DETAIL
AI	Azadirachta indica	Neem Tree	B & B	75mm Cal	4.0 M TALL	ADAPTED	8	1, CMPD L8.802
CH	Chamaerops humilis	Mediterranean Fan Palm	B & B	50mm Cal	Multi Stem	ADAPTED	22	4, CMPD L8.802
DR	Dracena reginae	Royal Poinciana	Box	75mm Cal	4.0 M TALL	ADAPTED	10	1, CMPD L8.802
FC	Ficus chinensis	Wild Banyan Tree	Box	75mm Cal	4.0 M TALL	ADAPTED	9	1, CMPD L8.802
PD	Phoenix dactylifera	Egyptian Palm	Box		3.5M to Base	ADAPTED	19	4, CMPD L8.802
SRQ	Phoenix dactylifera	Date Palm	Box		3.5M to Base	ADAPTED	52	4, CMPD L8.802

SHRUBS	BOTANICAL	COMMON	CONT	REMARKS	QTY	DETAIL
BA	Bougainvillea alexandrie	Bougainvillea	11 lit. pot	ADAPTED	10	2, CMPD L8.802
HS	Hibiscus syriacus	Rose of Sharon	11 lit. pot	ADAPTED	77	2, CMPD L8.802
RN	Nerium oleander 'Nana Grant'	Red Nerium	11 lit. pot	ADAPTED	150	2, CMPD L8.802
TM	Thevetia peruviana	Yellow Oleander Multi-Trunk	11 lit. pot	ADAPTED	194	3, CMPD L8.802

GROUND COVERS	BOTANICAL	COMMON	CONT	REMARKS	QTY	DETAIL
CF	Carpobrotus glaucescens	Fig Face	1 lit. @ 0.30m oc	ADAPTED	7,519	3, CMPD L8.802
VM	Catharanthus roseus	Madagascar Periwinkle	1 lit. @ 0.30m oc	ADAPTED	324	3, CMPD L8.802
IP	Ipomoea pes-caprae	Pohuehue	1 lit. @ 0.30m oc	ADAPTED	1,207	3, CMPD L8.802

REFERENCE NOTES SCHEDULE

SYMBOL	REFERENCE NOTES
1	EDGING, SEE DETAIL 5, CMPD L8.802
	LAWN
	ROCK MULCH

TRUE NORTH

PROJECT NORTH

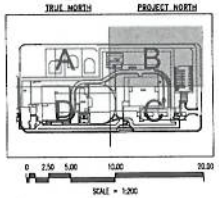

0 2.50 5.00 10.00 20.00

SCALE = 1:200

United States Department of State
OVERSEAS BUILDINGS OPERATIONS
Washington, D.C.

UNITED STATES EMBASSY
for
DJIBOUTI
REPUBLIC OF DJIBOUTI

WARNING: This document is the property of the U.S. Government. Further reproduction and/or distribution is prohibited without the express written permission of the Overseas Buildings Operations, U.S. Department of State, Washington, DC, 20521-0525. Information on this document is not to be shared except with the written approval of the individual whose and signature appears.

RECORD "AS-BUILT" DRAWING
THE INFORMATION ON THIS DRAWING INDICATES CHANGES MADE TO THE CONSTRUCTION DOCUMENTS AS RECORDED BY THE CONTRACTOR AND TRANSCRIBED TO THE REPRODUCIBLE DRAWING BY THE ARCHITECT. THE ARCHITECT ASSUMES NO RESPONSIBILITY FOR THE ACCURACY OR QUALITY OF THE INFORMATION PROVIDED

Rev Number	Description	Date
1	RECORD "AS-BUILT" DRAWING	

Revisions

CADDELL

INTÊGRUS ARCHITECTURE

Release For Construction

Drawing Title
LANDSCAPE PLAN 'B'

OBO Project Number: NA0604-08-C-0038
CADD File Name: CMPDL8.109
Drawing Scale: 1:200
Plot Scale:
Phase: ☐MASTER ☐PA ☐PA ☐PA ☐PA ☐PA

Date: 7-21-09
Drawn By: HJS
Checked By:
Project Number: 208.33.00
Sheet Number: CMPD L8.113
Classification: UNCLASSIFIED

RECORD "AS-BUILTS" DRAWING

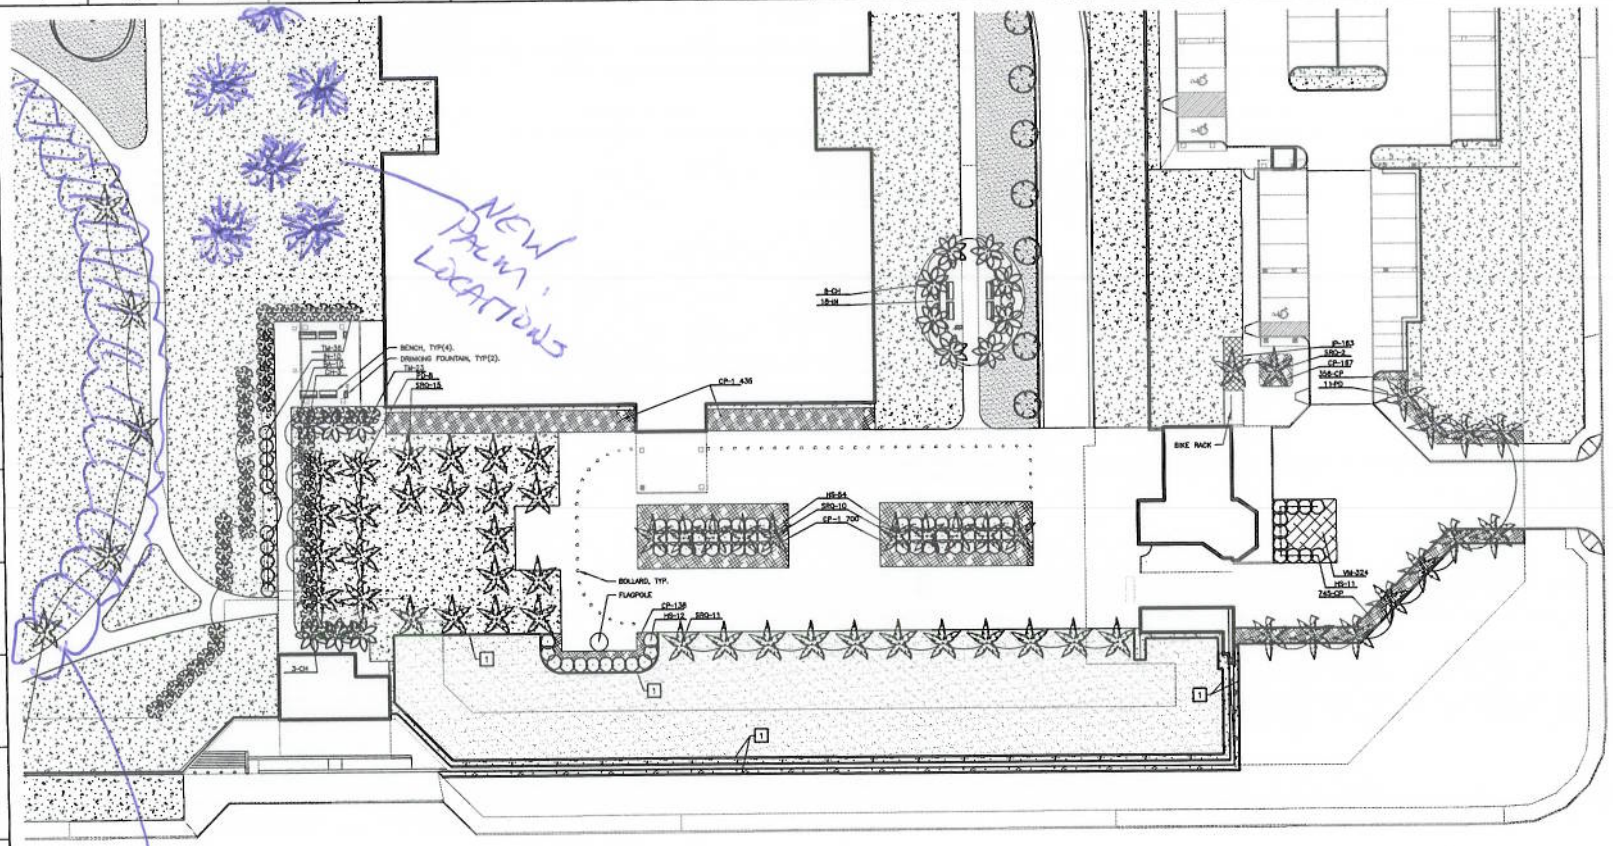

PLANT SCHEDULE

	BOTANICAL	COMMON	CONT	CAL	SIZE	REMARKS	QTY	DETAIL
TREES								
AI	Azadirachta indica	Neem Tree	B & B	75mm Cal	4.0 M TALL	ADAPTED	8	1, CMPD L8.502
CH	Chamaerops humilis	Mediterranean Fan Palm	B & B	50mm Cal	Multi Stem	ADAPTED	32	4, CMPD L8.502
DR	Delonix regia	Royal Poinciana	Box	75mm Cal	4.0 M TALL	ADAPTED	10	1, CMPD L8.502
FC	Ficus citrifolia	Wild Banyan Tree	Box	75mm Cal	4.0 M TALL	ADAPTED	9	1, CMPD L8.502
PD	Phoenix dactylifera	Egyptian Palm	Box		3.5M to Base	ADAPTED	18	4, CMPD L8.502
SRO	Phoenix dactylifera	Date Palm	Box		3.5M to Base	ADAPTED	52	4, CMPD L8.502
SHRUBS	**BOTANICAL**	**COMMON**	**CONT**			**REMARKS**		**DETAIL**
BA	Bougainvillea alexandrie	Bougainvillea	11 EL pot			ADAPTED	10	2, CMPD L8.502
HS	Hibiscus syriacus	Rose of Sharon	11 EL pot			ADAPTED	77	2, CMPD L8.502
IN	Ixora coccinea 'Nana Grant'	Red Ixora	11 EL pot			ADAPTED	150	2, CMPD L8.502
TM	Thevetia peruviana	Yellow Oleander Multi-Trunk	11 EL pot			ADAPTED	106	2, CMPD L8.502
GROUND COVERS	**BOTANICAL**	**COMMON**	**CONT**			**REMARKS**		**DETAIL**
CP	Carpobrotus glaucescens	Pig Face	1 EL @ 0.30m oc			ADAPTED	7,519	3, CMPD L8.502
VM	Catharanthus roseus	Madagascar Periwinkle	1 EL @ 0.30m oc			ADAPTED	324	3, CMPD L8.502
IP	Ipomoea pes-caprae	Pohuehue	1 EL @ 0.30m oc			ADAPTED	1,207	3, CMPD L8.502

REFERENCE NOTES SCHEDULE

SYMBOL	REFERENCE NOTES
	EDGING, SEE DETAIL 5, CMPD L8.502
	LAWN
	ROCK MULCH

TRUE NORTH

PROJECT NORTH

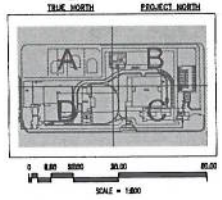

United States Department of State
OVERSEAS BUILDINGS OPERATIONS
Washington, D.C.

UNITED STATES EMBASSY
for
DJIBOUTI
REPUBLIC OF DJIBOUTI

WARNING: This document is the property of the U.S. Government. Further reproduction and/or distribution is prohibited without the express written permission of the Overseas Buildings Operations, U.S. Department of State, Washington, DC. 20521-0203. Unauthorized use of this document is an offense under 18 USC 1030 punishable by fine and/or imprisonment.

RECORD "AS-BUILT" DRAWING
THE INFORMATION ON THIS DRAWING INDICATES CHANGES MADE TO THE CONSTRUCTION DOCUMENTS AS RECORDED BY THE CONTRACTOR AND TRANSFERRED TO THE REPRODUCIBLE DRAWINGS BY THE ARCHITECT. THE ARCHITECT ASSUMES NO RESPONSIBILITY FOR THE ACCURACY OR RELIABILITY OF THE INFORMATION PROVIDED.

Rev. Number	Description	Date
	RECORD "AS-BUILT" DRAWING	

Reviewed

CADDELL

INTÊGRUS ARCHITECTURE

Release For Construction

Drawing Title
LANDSCAPE PLAN 'C'

CAD Project Number: 20833A-00-C-0030
CAD File Name: CMPDL8.110
Drawing Scale: 1:200
Plot Date:
Plot: ☐ 24X36 ☐ 8X11 ☐ 11X17 ☐ 22X34 ☐ 34X44

Date: 7-21-09
Drawn By: HJS
Checked By:
Project Number: 20833.00
Classification: UNCLASSIFIED

Sheet Number: CMPD L8.114

RECORD "AS-BUILTS" DRAWING

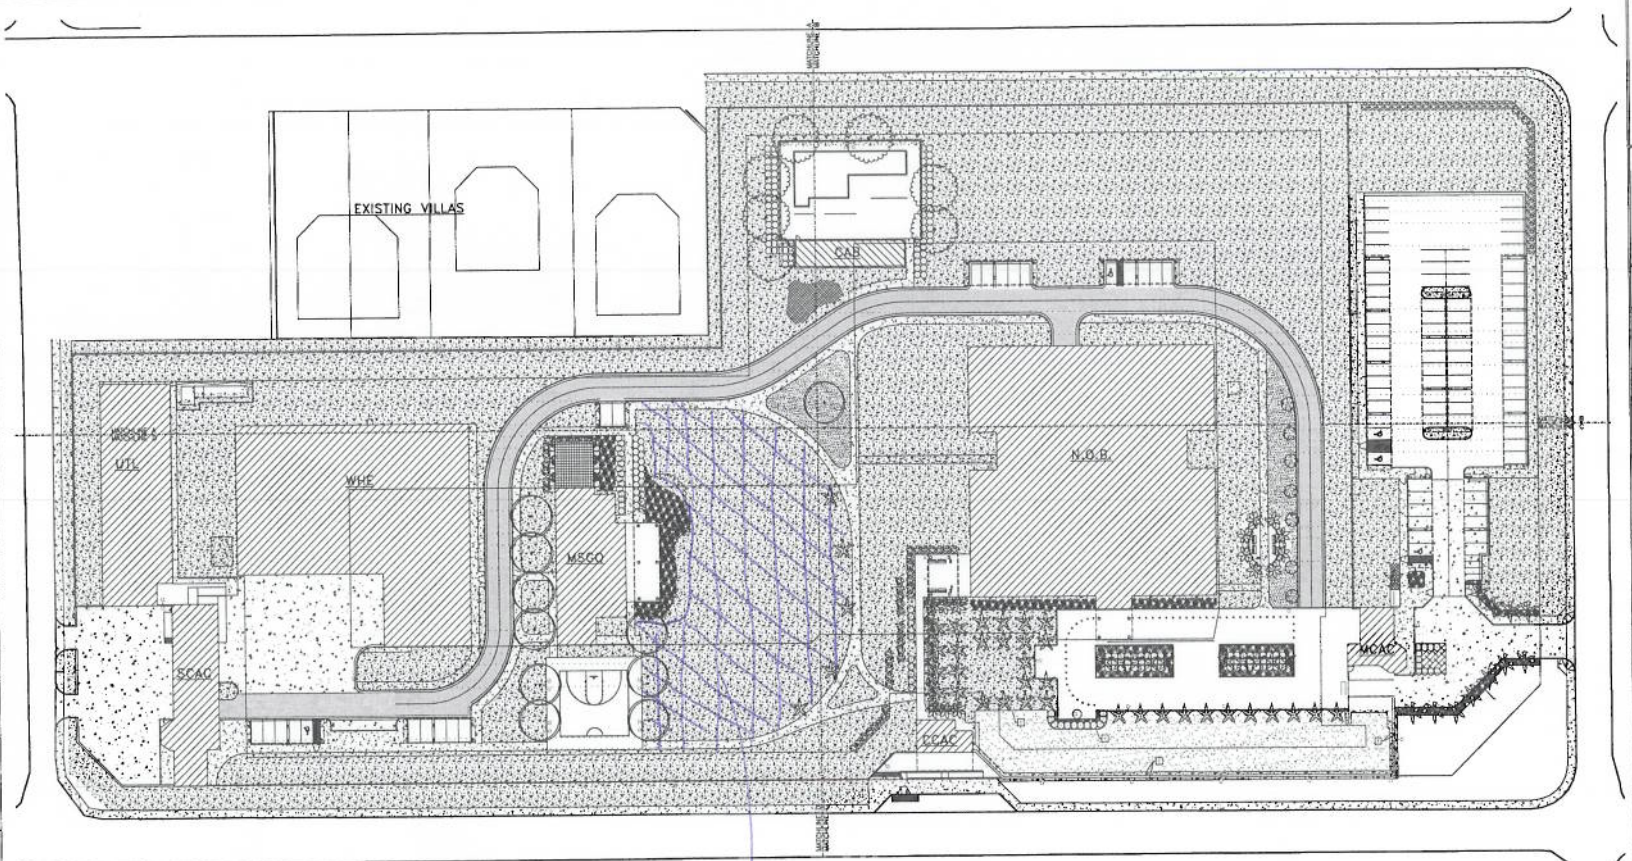

NEW ARTIFICIAL TURF LOCATION

PLANT SCHEDULE

	BOTANICAL	COMMON	CONT	CAL	SIZE	REMARKS	QTY	DETAIL
TREES								
AI	Azadirachta indica	Neem Tree	B & B	75mm Cal	4.0 M TALL	ADAPTED	8	1, CMPD L8.802
CH	Chamaerops humilis	Mediterranean Fan Palm	B & B	50mm Cal	Multi Stem	ADAPTED	22	4, CMPD L8.802
SR	Delonix regia	Royal Poinciana	Box	75mm Cal	4.0 M TALL	ADAPTED	10	1, CMPD L8.802
FC	Ficus citrifolia	Wild Banyan Tree	Box	75mm Cal	4.0 M TALL	ADAPTED	9	1, CMPD L8.802
PD	Phoenix dactylifera	Egyptian Palm	Box		3.5M to Base	ADAPTED	19	4, CMPD L8.802
SRQ	Phoenix dactylifera	Date Palm	Box		3.5M to Base	ADAPTED	52	4, CMPD L8.802
SHRUBS								
BA	Bougainvillea alexandrie	Bougainvillea	11 lit. pot			ADAPTED	10	2, CMPD L8.802
HS	Hibiscus syriacus	Rose of Sharon	11 lit. pot			ADAPTED	77	2, CMPD L8.802
IN	ixora coccinea 'Nana Grant'	Red Ixora	11 lit. pot			ADAPTED	150	2, CMPD L8.802
TU	Thevetia peruviana	Yellow Oleander Multi-Trunk	11 lit. pot			ADAPTED	156	2, CMPD L8.802
GROUND COVERS								
CP	Carpobrotus glaucescens	Pig Face	1 lit. @ 0.30m oc			ADAPTED	7,519	3, CMPD L8.802
VM	Catharanthus roseus	Madagascar Periwinkle	1 lit. @ 0.30m oc			ADAPTED	324	3, CMPD L8.802
IP	Ipomoea pes-caprae	Pohuehue	1 lit. @ 0.30m oc			ADAPTED	1,207	3, CMPD L8.802

REFERENCE NOTES SCHEDULE

SYMBOL	REFERENCE NOTES
1	EDGING, SEE DETAIL 5, CMPD L8.802
	LAWN
	ROCK MULCH

TRUE NORTH

PROJECT NORTH

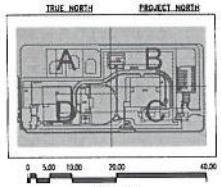

0 5.00 10.00 20.00 40.00

SCALE = 1:400

United States Department of State
OVERSEAS BUILDINGS OPERATIONS
Washington, D.C.

UNITED STATES EMBASSY
for
DJIBOUTI
REPUBLIC OF DJIBOUTI

WARNING: This document is the property of the U.S. Government. Further reproduction and/or distribution is prohibited without the express written permission of Overseas Buildings Operations, U.S. Department of State, Washington, DC, 20520-0525 (Attention: [illegible]). This document is not to be altered except with the written approval of the Contractor stamp and signature herein.

RECORD "AS-BUILT" DRAWING
THE FOLLOWING INFORMATION PROVIDED ON THIS DRAWING INDICATES CHANGES MADE TO THE CONSTRUCTION DOCUMENTS AS RECORDED BY THE CONTRACTOR AND TRANSMITTED TO THE REPRODUCIBLE DRAWINGS BY THE ARCHITECT. THE ARCHITECT ASSUMES NO RESPONSIBILITY FOR THE ACCURACY OR REALIBILITY OF THE INFORMATION PROVIDED.

Rev. Number	Description	Date
1	RECORD "AS-BUILT" DRAWING	8/17/11
Revisions		

CADDELL

INTÊGRUS ARCHITECTURE

Release for Construction

Drawing Title: OVERALL LANDSCAPE PLAN

CDD Project Number: 04AFRA-06-C-0036
CADD File Name: CMPDL8.107
Drawing Scale: 1:400
Plot Scale:
Plans: ☐ 100% ☐ 50 ☐ 25 ☐ 10 ☐ 5 ■ FULL

Date: 7-21-09
Drawn By: HJS
Checked By:
Project Number: 20833.00
Sheet Number: CMPD L8.111
Classification: UNCLASSIFIED

RECORD "AS-BUILTS" DRAWING