Add Alternate #2

UNCLASSIFIED

DRAWING NOTES

1. ALL CONDUIT IS (2)2"(51mm) PVC UNLESS NOTED OTHERWISE.
2. ALL PULL BOXES ARE 12" x 12" x 6"(305mm x 305mm x 152mm), NEMA 3 AND LOCKABLE UNLESS NOTED OTHERWISE.

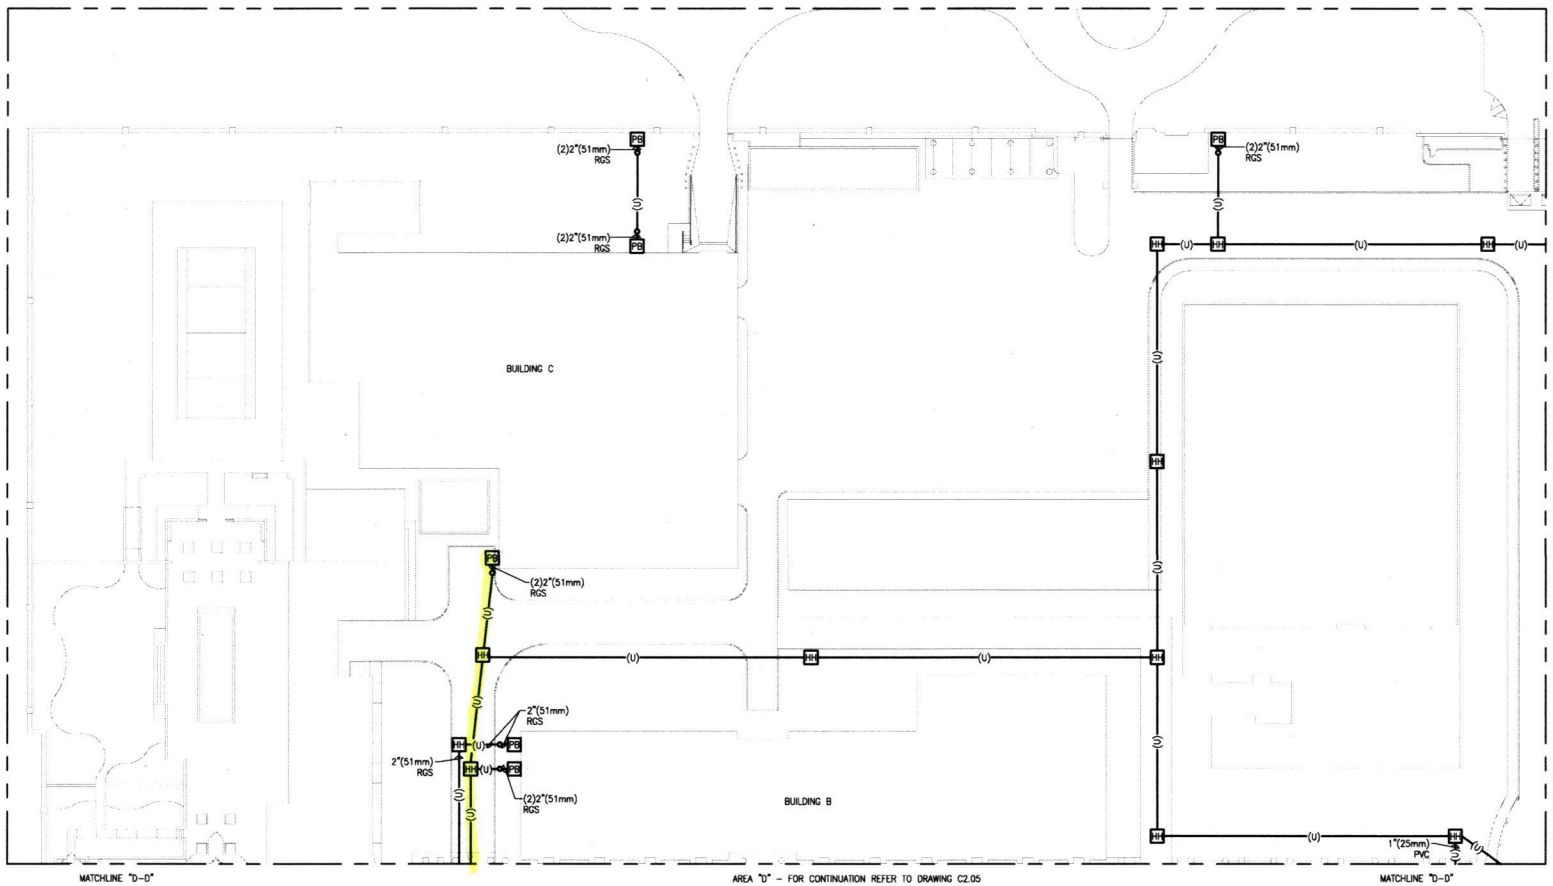

SITE PLAN - AREA "A"
SCALE: 1:300

UNCLASSIFIED

LOCAL CONTRACTOR PACKAGE for KUWAIT CITY, KUWAIT

WARNING: This document is the property of the U.S. Government. Further reproduction and/or distribution is prohibited without the express written consent of The U.S. Department of State, Washington, DC. 20522-0600. Unauthorized use of this document and its contents may be in violation of the Federal Law and Regulations.

KEYPLAN

GRAPHICAL SCALES
1:300: 0, 6000, 12000, 30000mm; 0, 3250, 9750, 16250, 96 ft; 0, 16', 32', 48'

DRAWING TITLE: SITE PLAN AREA "A" NEW WORK

PHASE: ☐ 30% ☐ 90% ■ 100% ☐ AS-BUILT

CAD FILE NAME: KWID202.dwg
DRAWING SCALE: AS NOTED
PROJECT NUMBER: KUWAIT CITY-PME-15027
DRAWN BY: HT/BM
DESIGNED BY: RR
DATE: 08/04/15
DRAWING NUMBER: C2.02
SHEET 5 OF 10
CLASSIFICATION: UNCLASSIFIED
REV.

Add Alternate #2

UNCLASSIFIED

DRAWING NOTES

1. ALL CONDUIT IS (2)2"(51mm) PVC UNLESS NOTED OTHERWISE.
2. ALL PULL BOXES ARE 12" x 12" x 6"(305mm x 305mm x 152mm), NEMA 3 AND LOCKABLE UNLESS NOTED OTHERWISE.

DRAWING KEY NOTES

1. 6" x 6" x 4"(152mm x 152mm x 101mm) NEMA 3 PULL BOX.
2. TRANSITION FROM PVC TO RGS USING A 2"(51mm) RGS 90° SWEEP.
3. STUB RGS CONDUIT ABOVE GROUND AT A MINIMUM OF 12" (305mm) AND CAP WITH END FITTING.

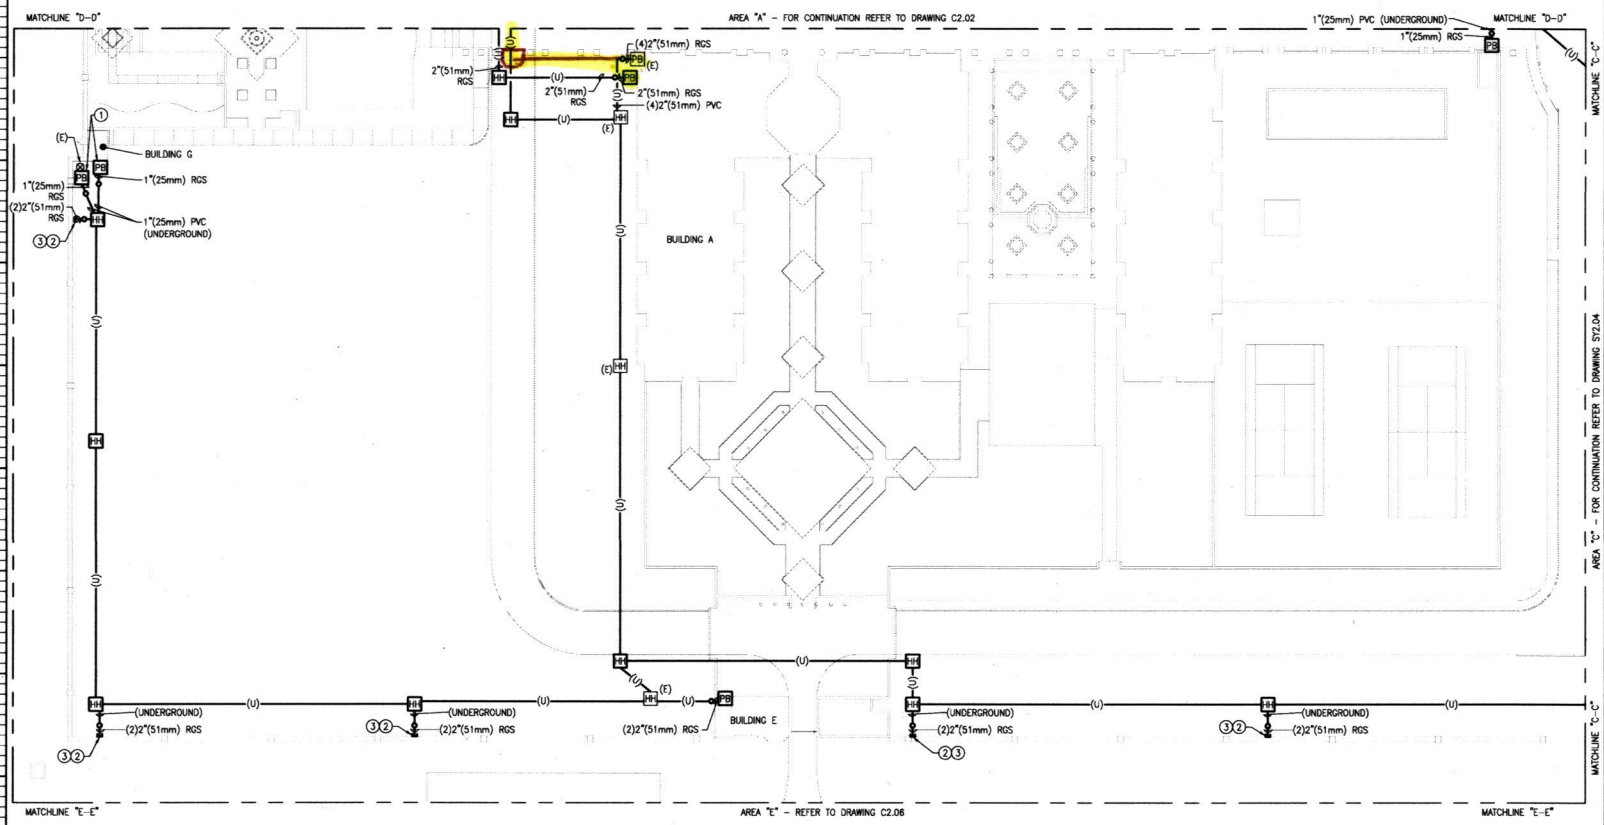

SITE PLAN – AREA "D"

SCALE: 1:300

UNCLASSIFIED

LOCAL CONTRACTOR PACKAGE for KUWAIT CITY, KUWAIT

WARNING: This document is the property of the U.S. Government. Further reproduction only with the author's permission. Other uses, reproduction, or publication of this document or any part thereof, without permission of the author, is prohibited by law. Unauthorized possession of this document, or any part thereof, is a violation of Federal Law. Violators will be prosecuted.

KEYPLAN

GRAPHICAL SCALES 1:300

SITE PLAN AREA "D" NEW WORK

DRAWING TITLE

PHASE: 30% 90% 100% AS-BUILT

CAD FILE NAME: KWID205.dwg

DRAWING SCALE: AS NOTED

PROJECT NUMBER: KUWAIT CITY-PME-15027

DRAWN BY: HY/BM

DESIGNED BY: RR

DATE: 08/04/15

DRAWING NUMBER: C2.05

SHEET 8 OF 10

CLASSIFICATION: UNCLASSIFIED

REV.
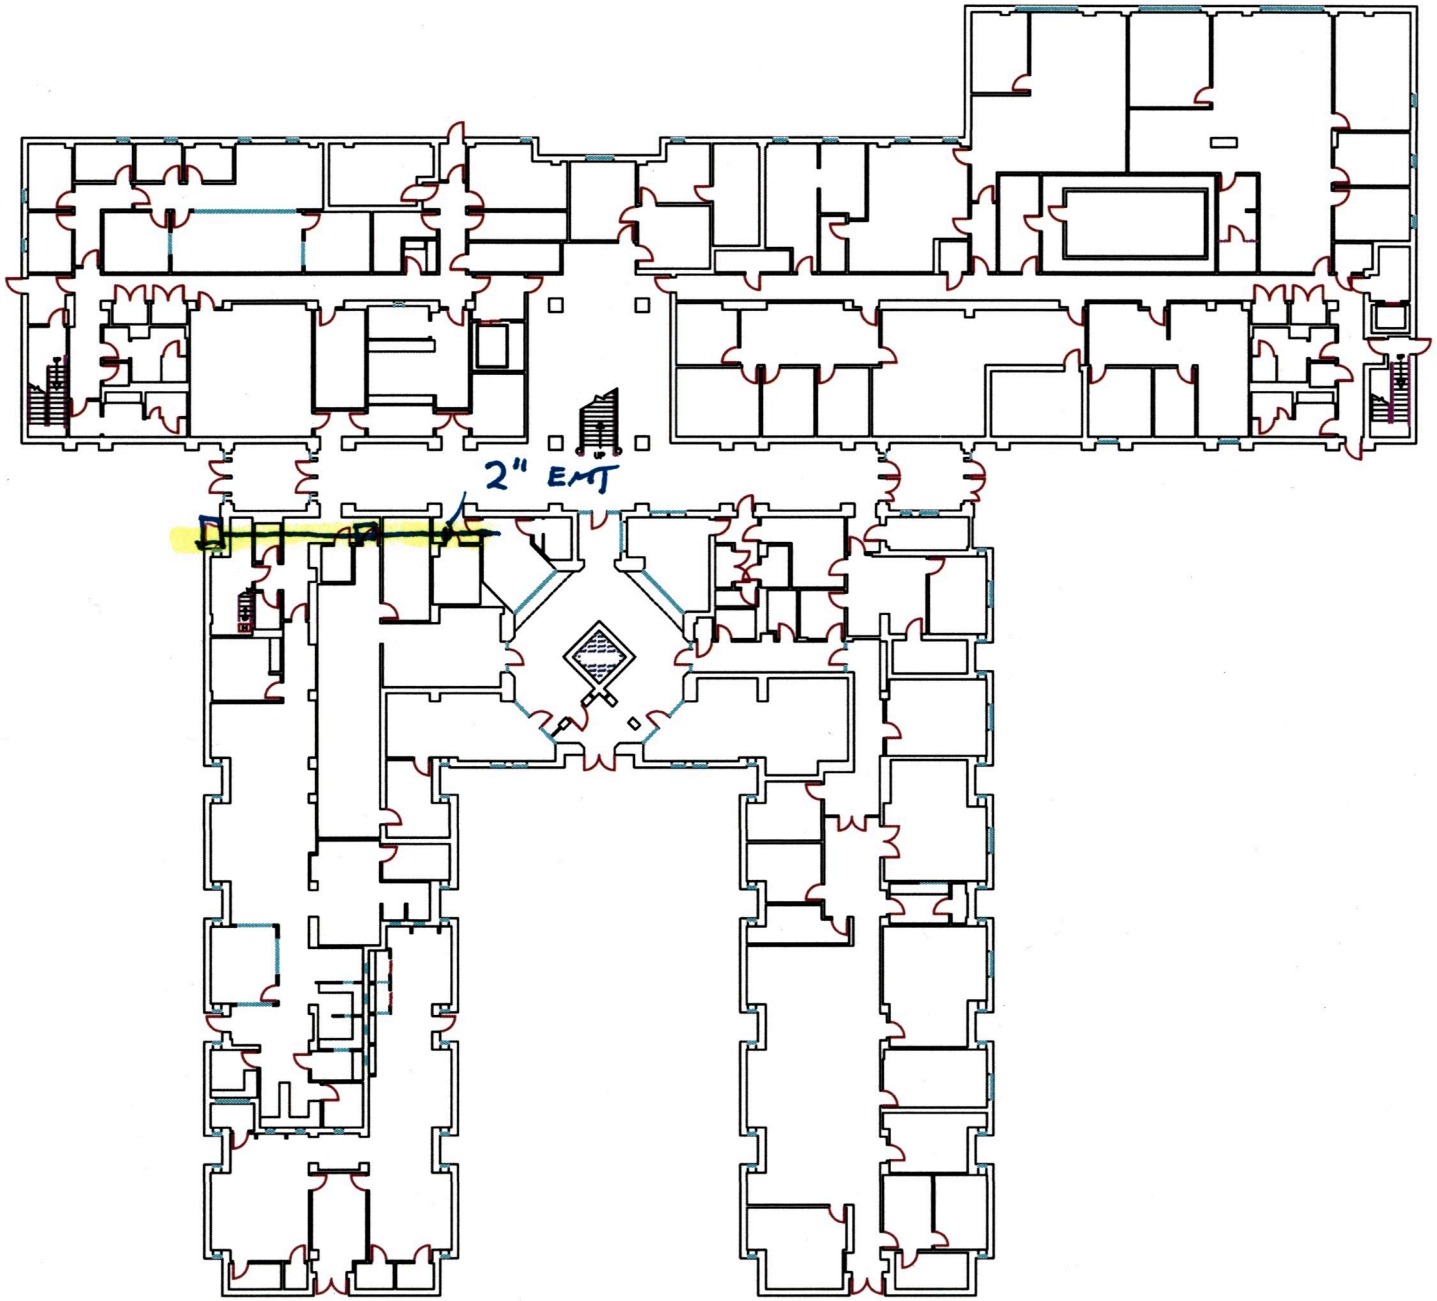
Add Alternate #2