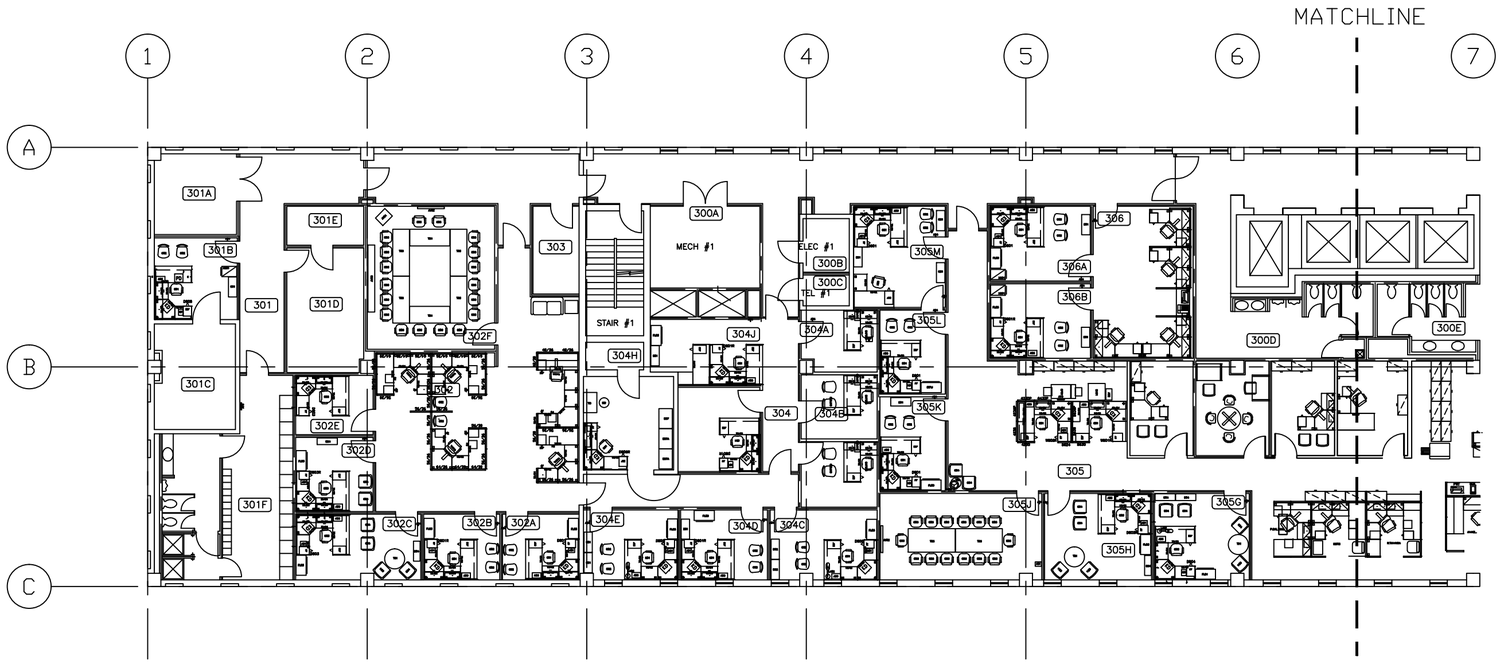

PARTIAL THIRD FLOOR PLAN
SCALE: 1:100

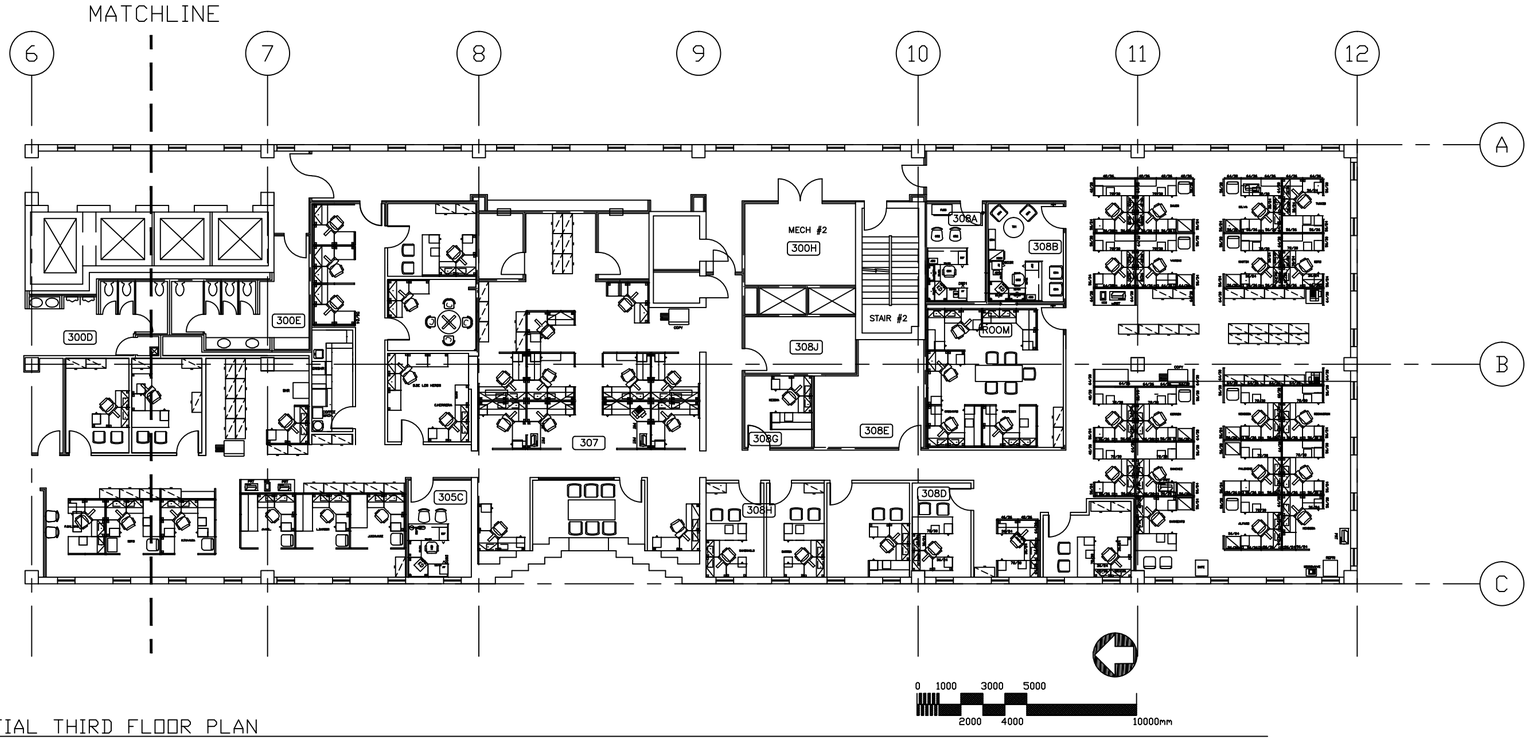

PARTIAL THIRD FLOOR PLAN
SCALE: 1:100

DATE : 01-06-2011	USA EMBASSY LIMA	UNCLASSIFIED
DRAWN BY : MFB		ESCALE: 1/100
CHECKED BY : RSC	CHANCERY : THIRD FLOOR-FURNITURE AS BUILT	NUMBER : F003